





LEGEND	
--- 498 ---	EXISTING GROUND CONTOUR
—	EDGE OF PAVEMENT
—	EXISTING LOT 1 PROPERTY LINE
—	WELL ISOLATION ZONE
—	SEPTIC ISOLATION ZONE
—	SEPTIC EASEMENTS
—	EXISTING LOT 2 & LOT 3
—	PROPOSED WATER LINE
—	PROPOSED SEPTIC LINE
—	PROPOSED LOT 4
⊙	WELL - DRILLED

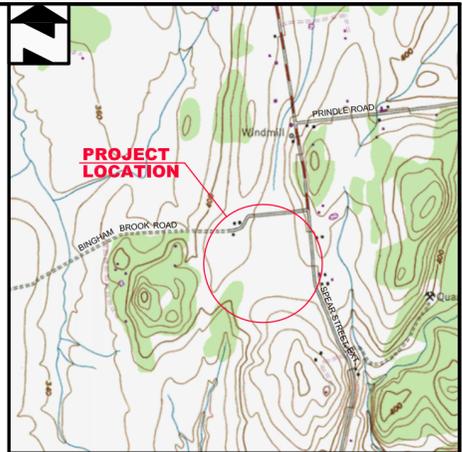

GENERAL LOCATION MAP
SCALE: 1"=2,000'±

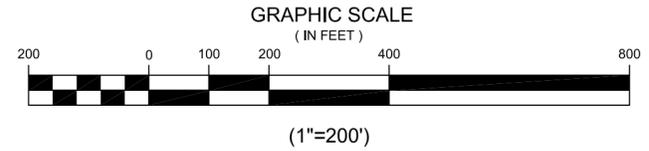

No.	REVISION	DATE
1	ADDED LOT 4 AS-BUILT	5/15/2015
2		
3		
4		

"I hereby certify the installation and related information submitted is true and correct and that in the exercise of my reasonable professional judgement, the approved water and wastewater disposal systems have been installed in accordance with the design, all design conditions and the "as-built" drawing were inspected, were properly tested and successfully met those performance tests."

Stephen Revell
 Stephen Revell, CPD
 Licensed Class B Designer #178

5-15-15
 Date



Trono Property
 800 Bingham Brook Road
 Charlotte, Vermont

Overall Property Site Plan

LAG PROJECT #:	10077
DATE:	Dec. 3, 2013
SURVEYORS:	D. Ring & LAG
DRAWN BY:	TAM
PLAN SHEET:	1