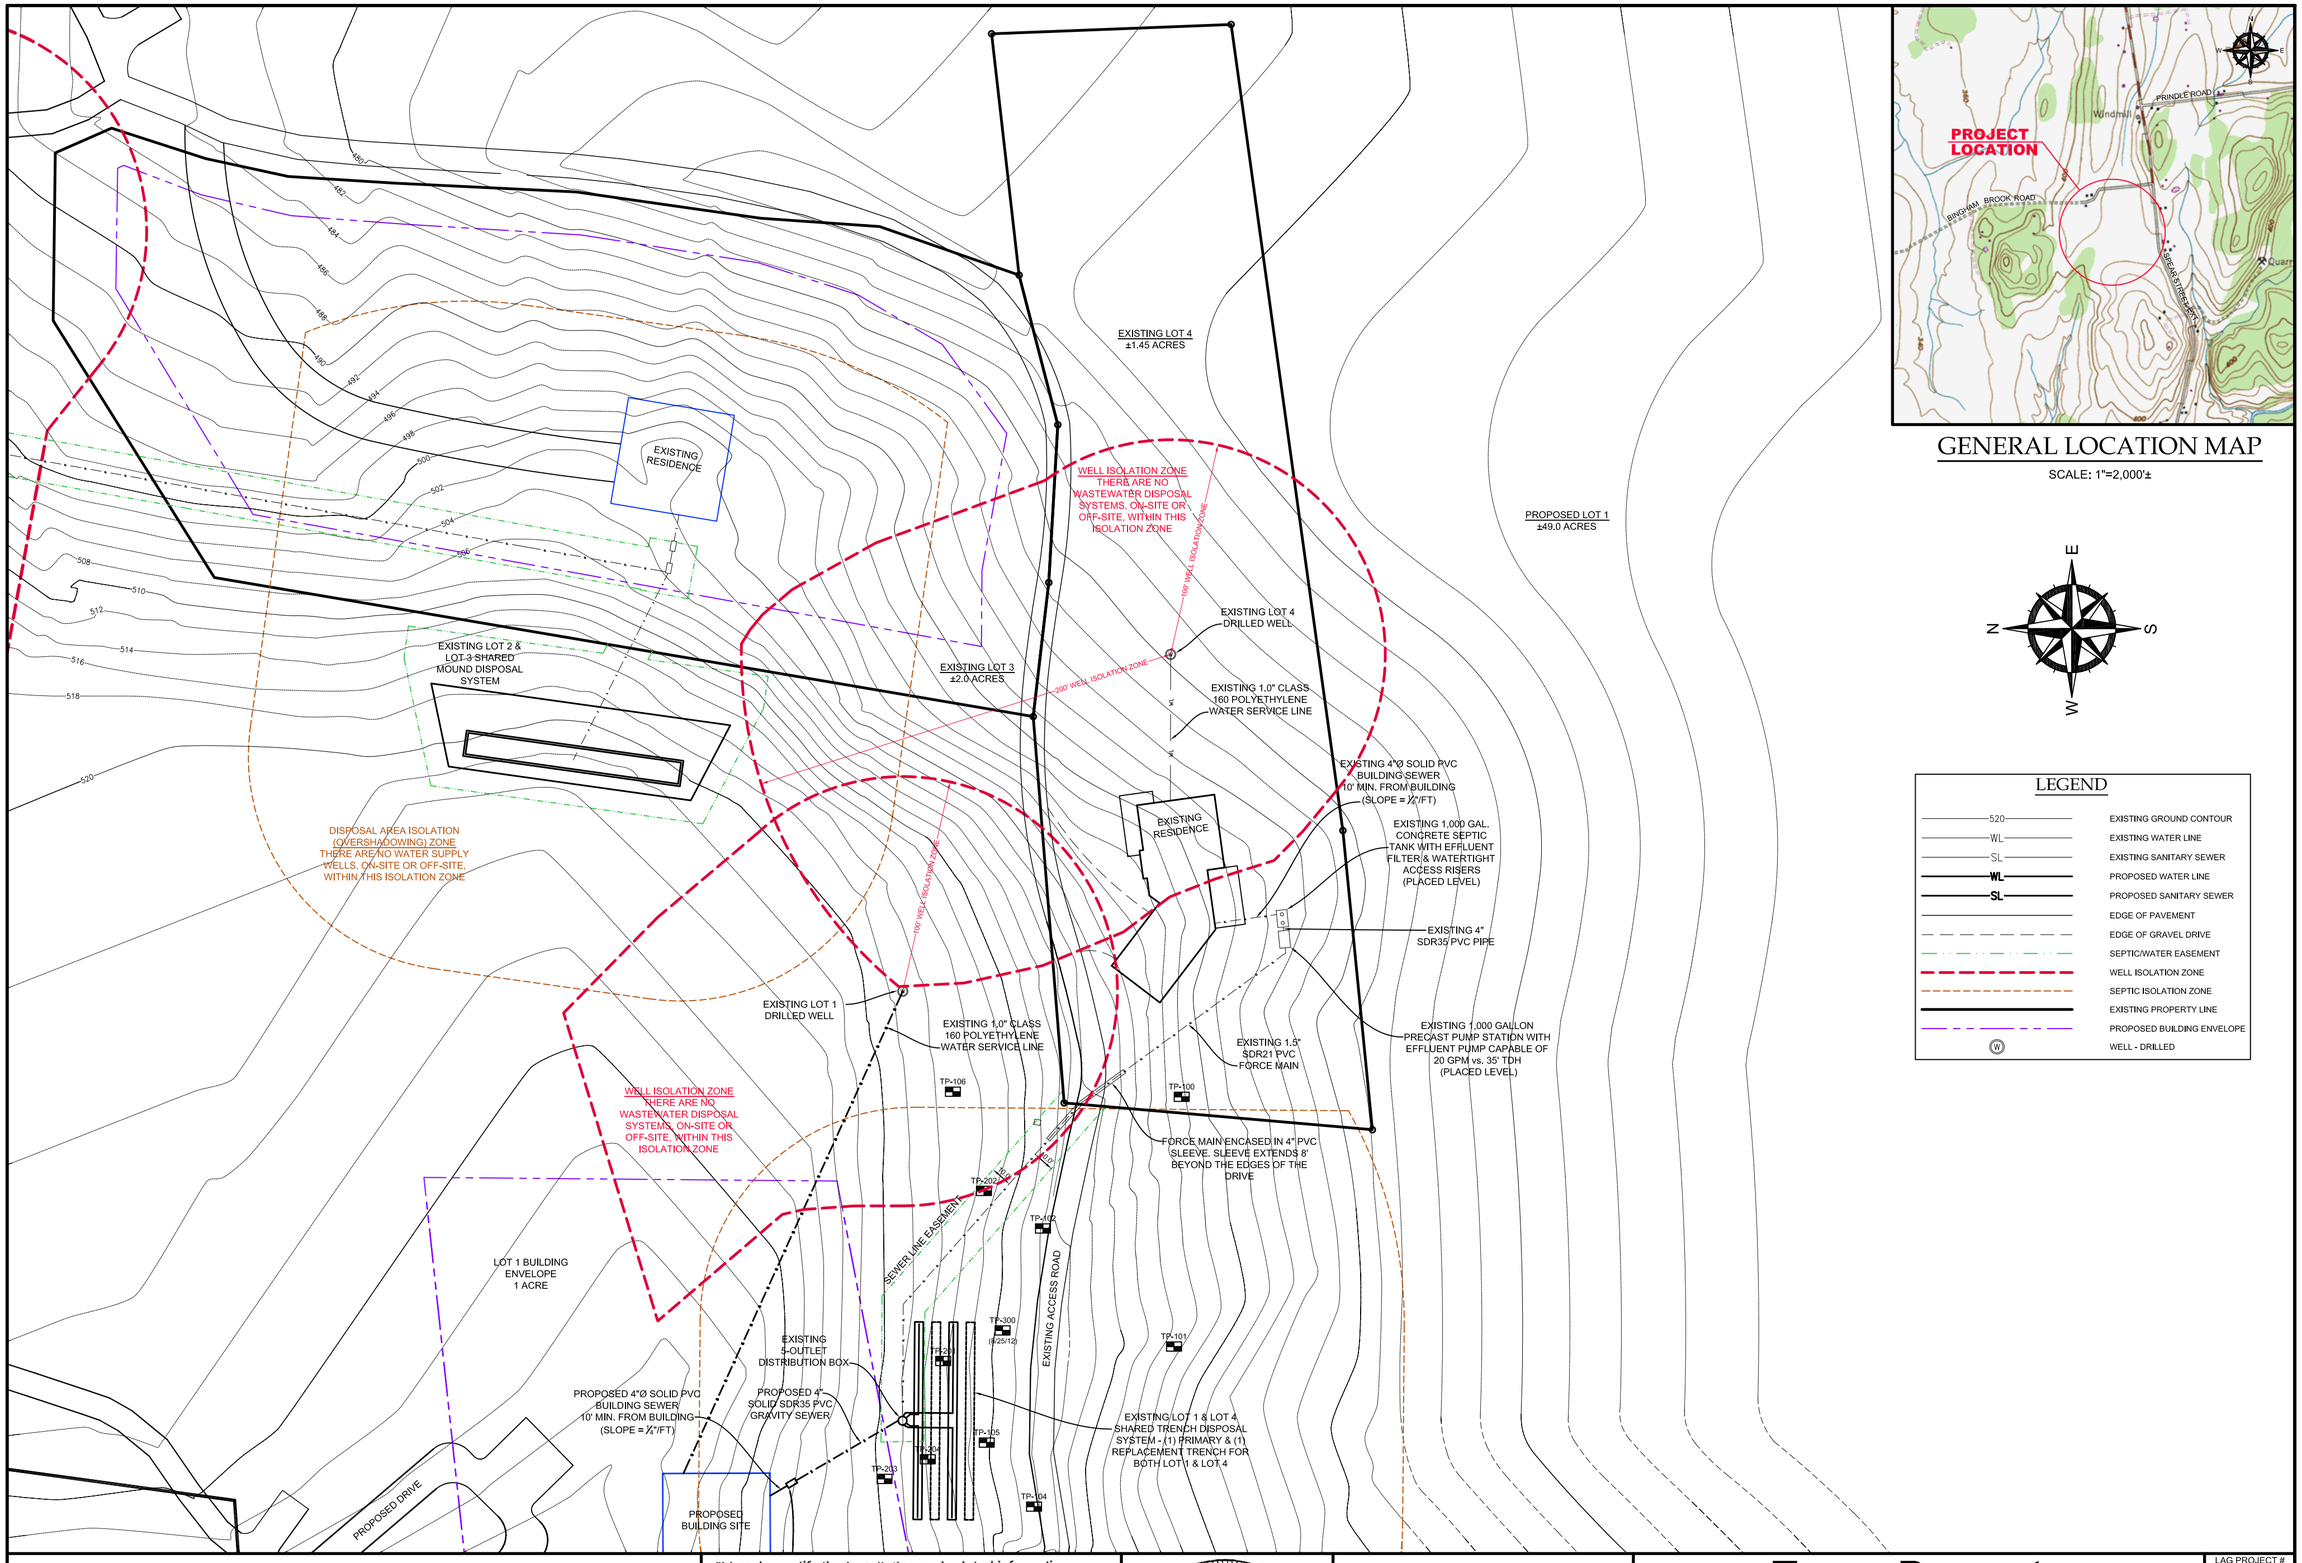

GENERAL LOCATION MAP

SCALE: 1"=2,000'±

N E S W

LEGEND

520	EXISTING GROUND CONTOUR
WL	EXISTING WATER LINE
SL	EXISTING SANITARY SEWER
WL	PROPOSED WATER LINE
SL	PROPOSED SANITARY SEWER
	EDGE OF PAVEMENT
	EDGE OF GRAVEL DRIVE
	SEPTIC/WATER EASEMENT
	WELL ISOLATION ZONE
	SEPTIC ISOLATION ZONE
	EXISTING PROPERTY LINE
	PROPOSED BUILDING ENVELOPE
W	WELL - DRILLED

GRAPHIC SCALE
(IN FEET)
50 0 25 50 100 200
(1"=50')

"I hereby certify the installation and related information submitted is true and correct and that in the exercise of my reasonable professional judgement, the approved water and wastewater disposal systems have been installed in accordance with the design, all design conditions and the "as-built" drawing were inspected, were properly tested and successfully met those performance tests."

5-15-15
Date

Stephen Revell, CPG
Licensed Class B Designer #178

AMERICAN INSTITUTE OF PROFESSIONAL GEOLOGISTS
CERTIFICATE NUMBER
6259
AIPG
STEPHEN REVELL
CERTIFIED PROFESSIONAL GEOLOGIST

LINCOLN APPLIED GEOLOGY, INC.
ENVIRONMENTAL CONSULTANTS
163 Revell Drive
(802) 453-4384
Web : www.lagvt.com
Lincoln, Vermont 05443
(802) 453-4399 (fax)
E-Mail: lagvt@lagvt.com

Trono Property

(Lot 4) Mandy's Way
Charlotte, Vermont

As-Built

Existing Site Plan showing
Existing Water & Wastewater Systems

LAG PROJECT #	10077
DATE:	May 15, 15
SURVEYORS:	TAM/DN
DRAWN BY:	TAM
FIGURE #:	2