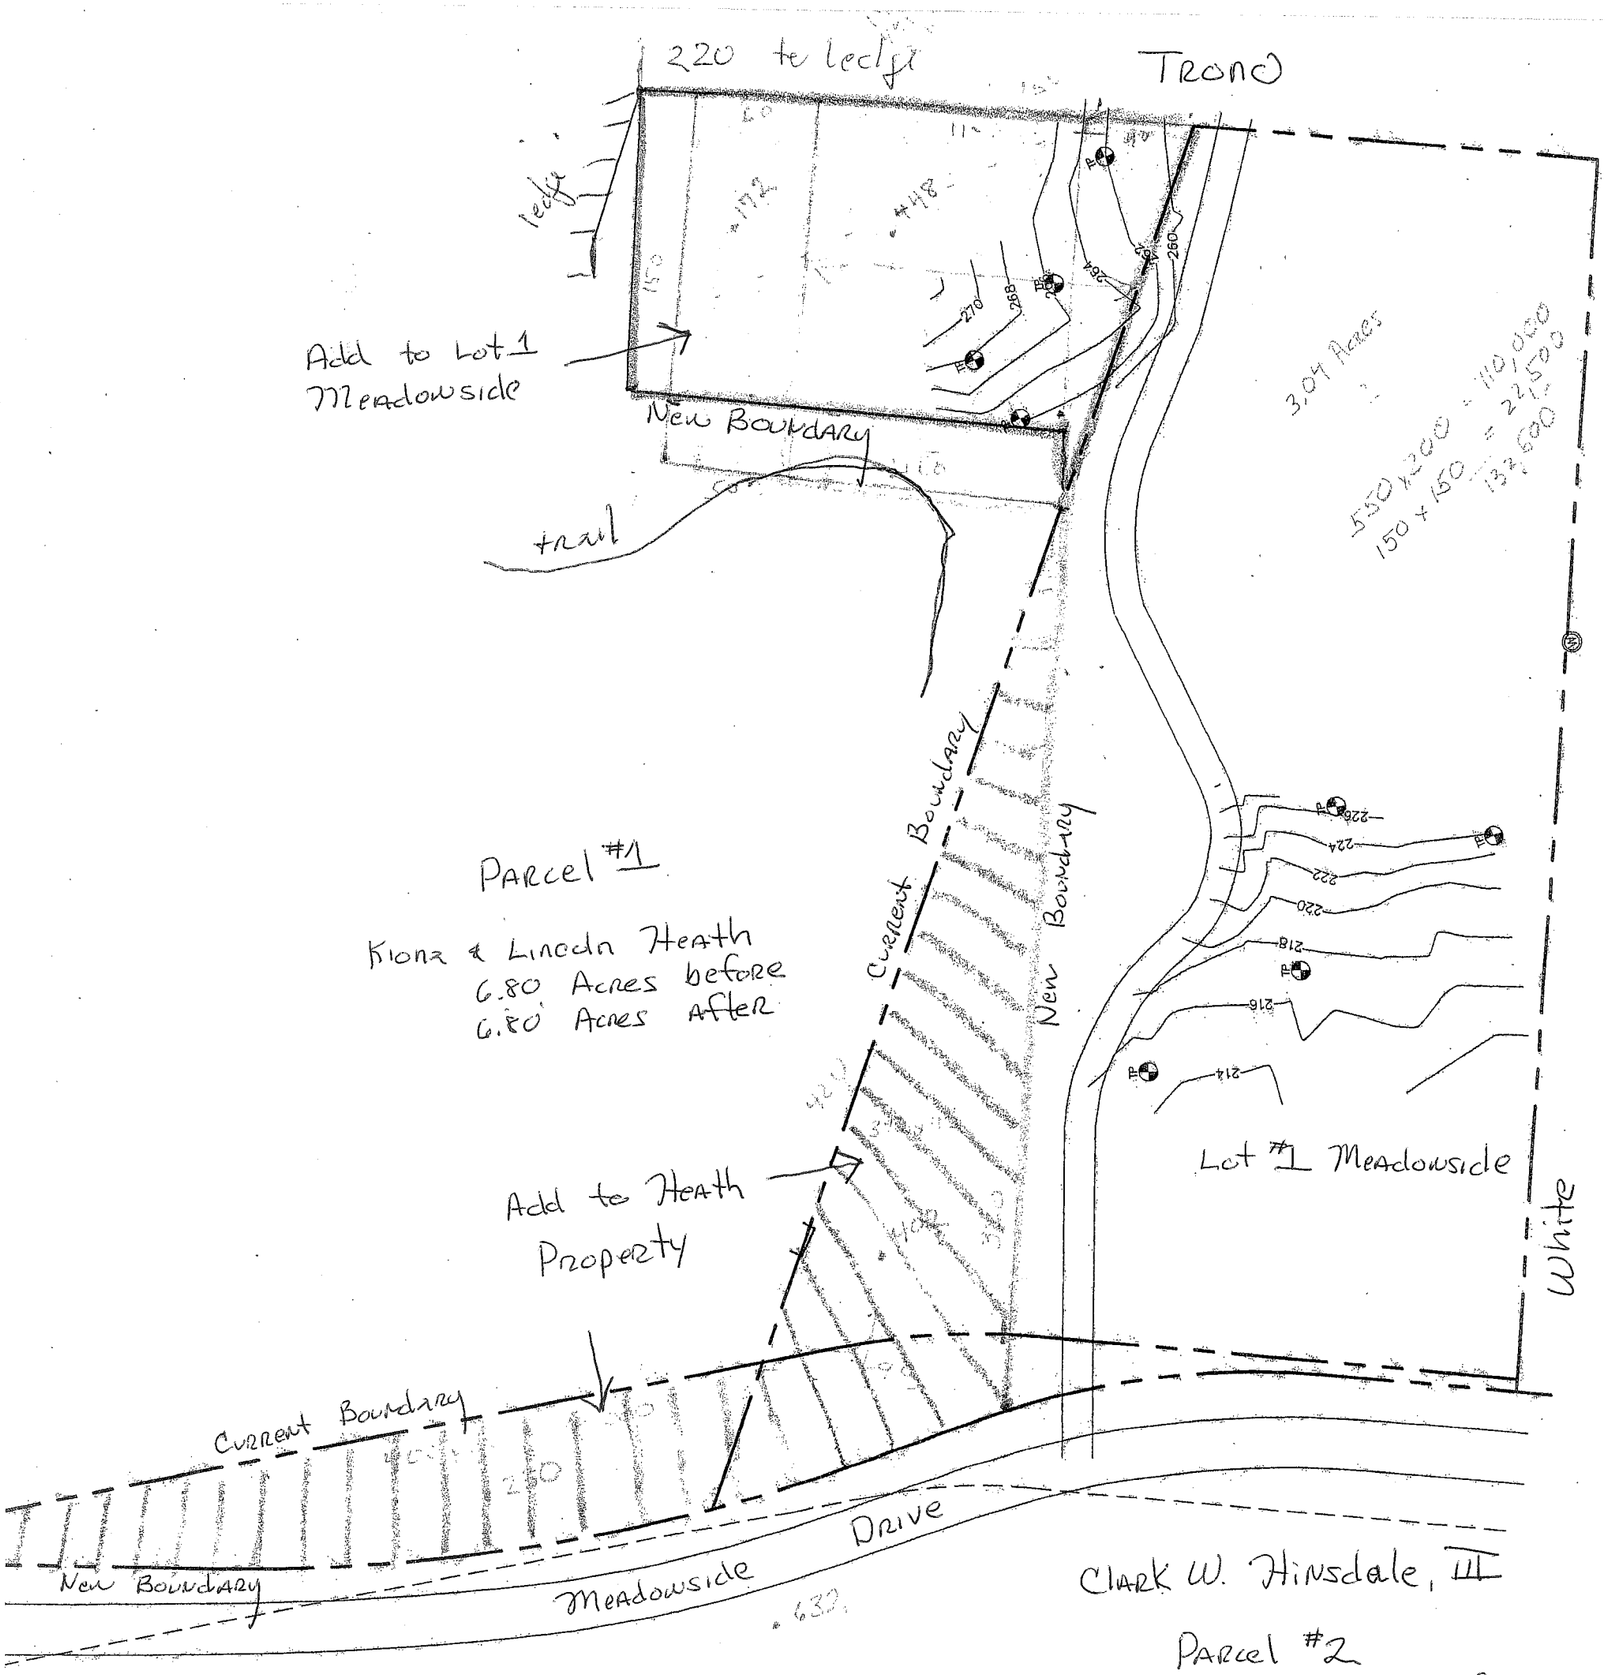

Proposed Subdivision Amendment
between
Kiona & Lincoln Heath
and
Clark W. Hinsdale, III

0 100 200
scale in feet

North

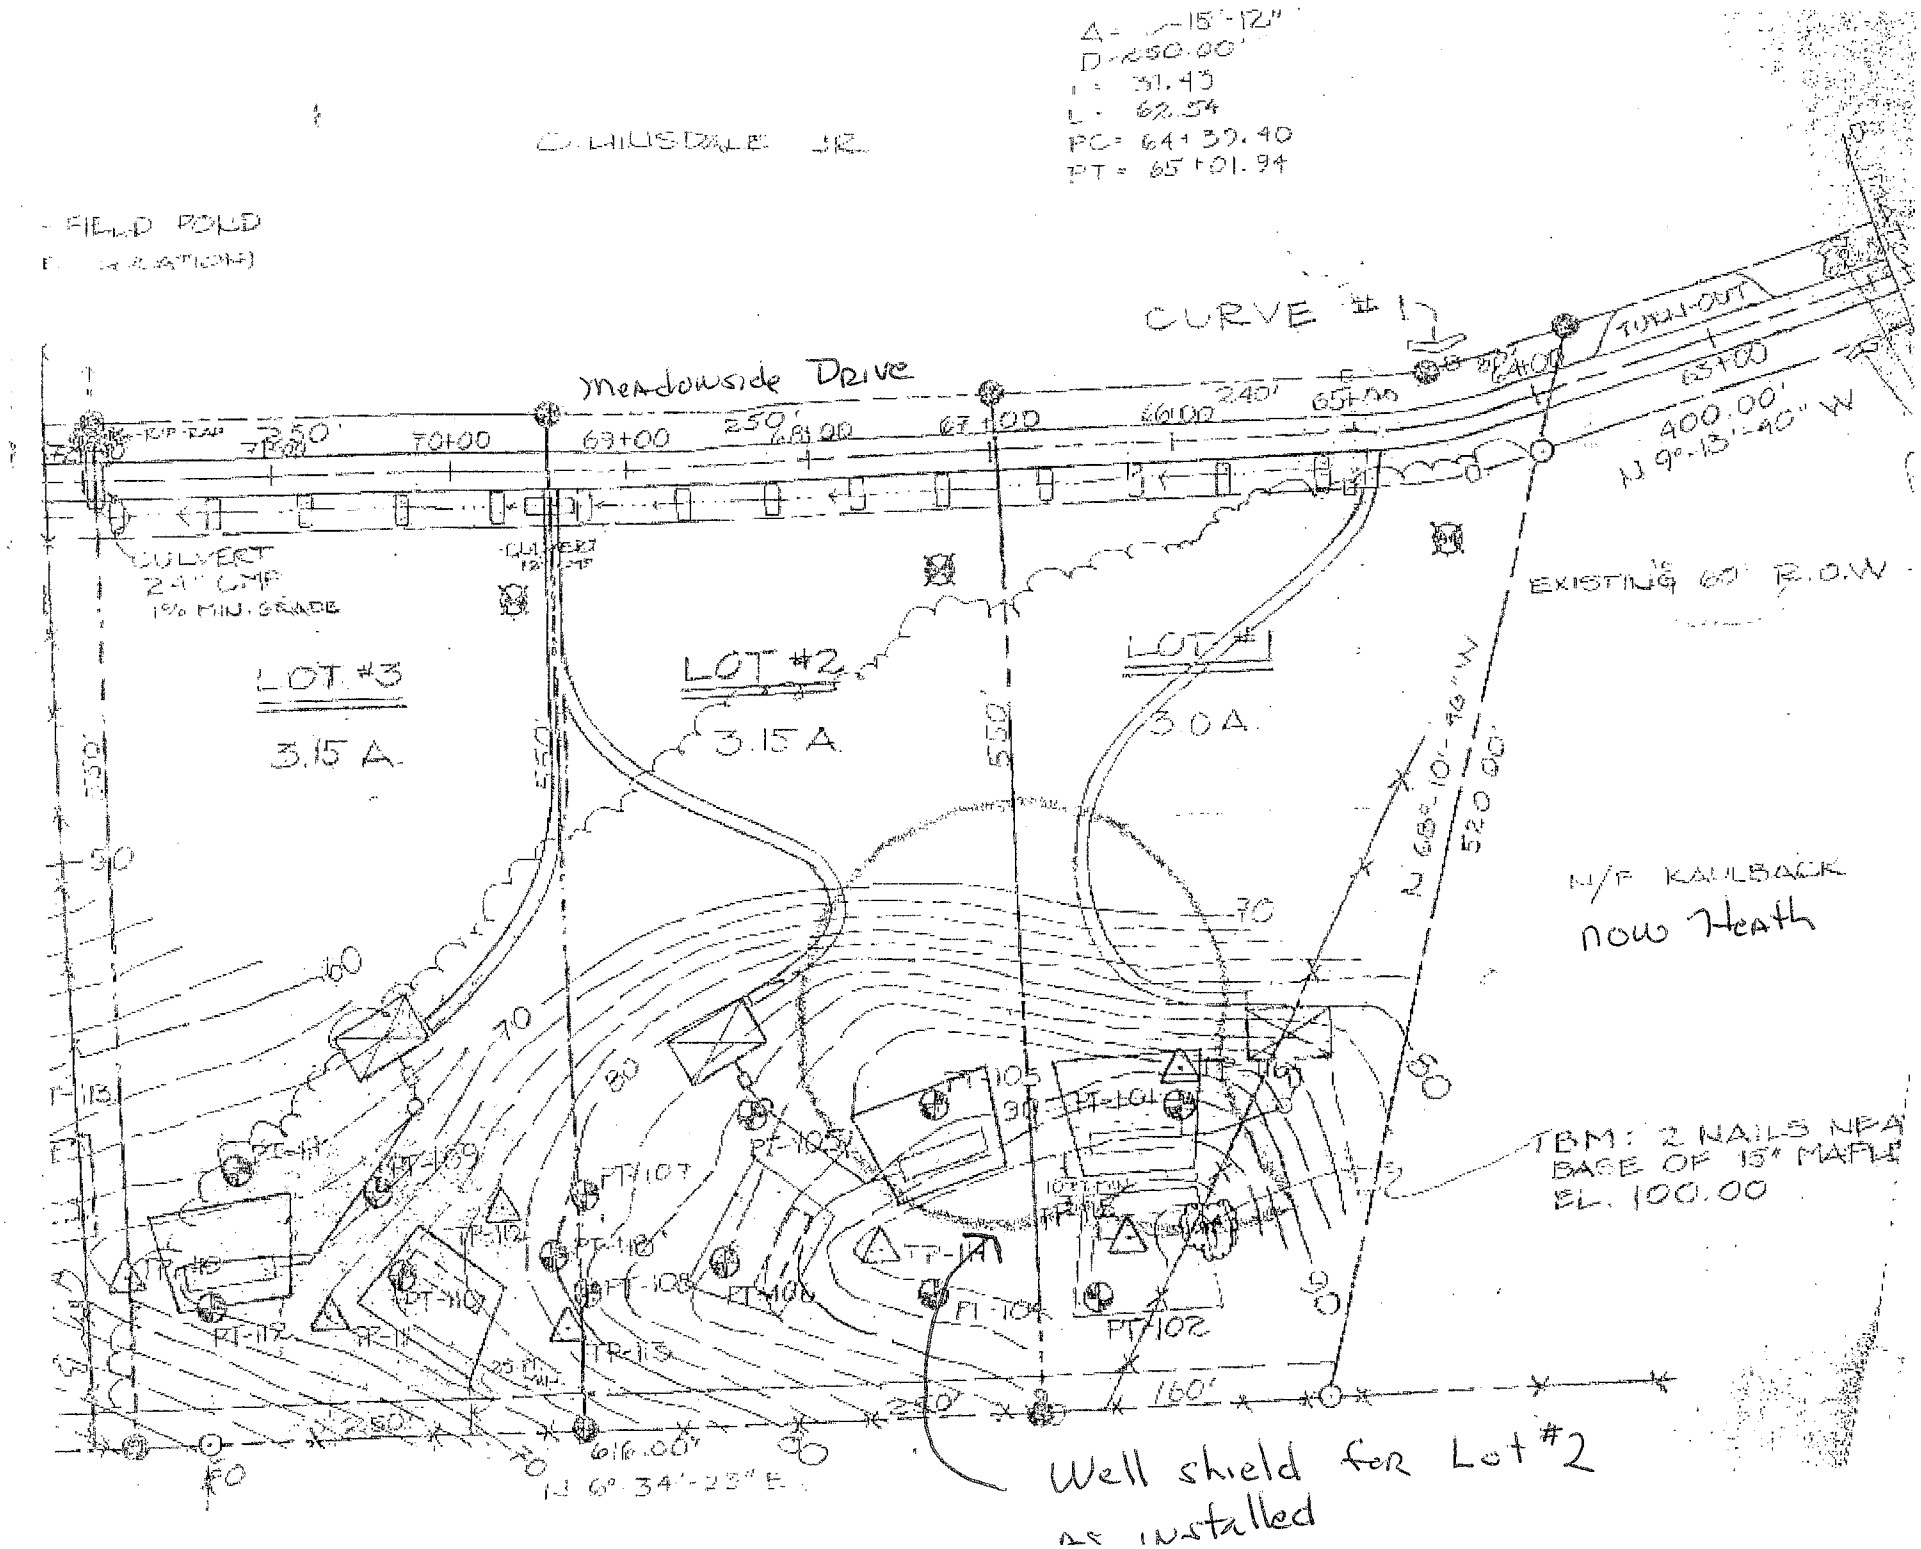
Δ = 15°-12"
D = 250.00'
T = 31.43
L = 62.54
PC = 64+39.40
PT = 65+01.94
C. HILLSDALE JR.
FIELD POND
CURVE #1
Meadowside Drive
TURN-OUT
63+00
400.00'
N 9°-13'-40" W
CULVERT
24" CMP
1% MIN. GRADE
EXISTING 60' R.O.W.
LOT #3
3.15 A.
LOT #2
3.15 A.
LOT #1
3.0 A.
N/F KAULBACK
now Heath
TBM: 2 NAILS NEA
BASE OF 15" MAPLE
EL. 100.00
N 6°-34'-23" E
Well shield for Lot #2
as installed