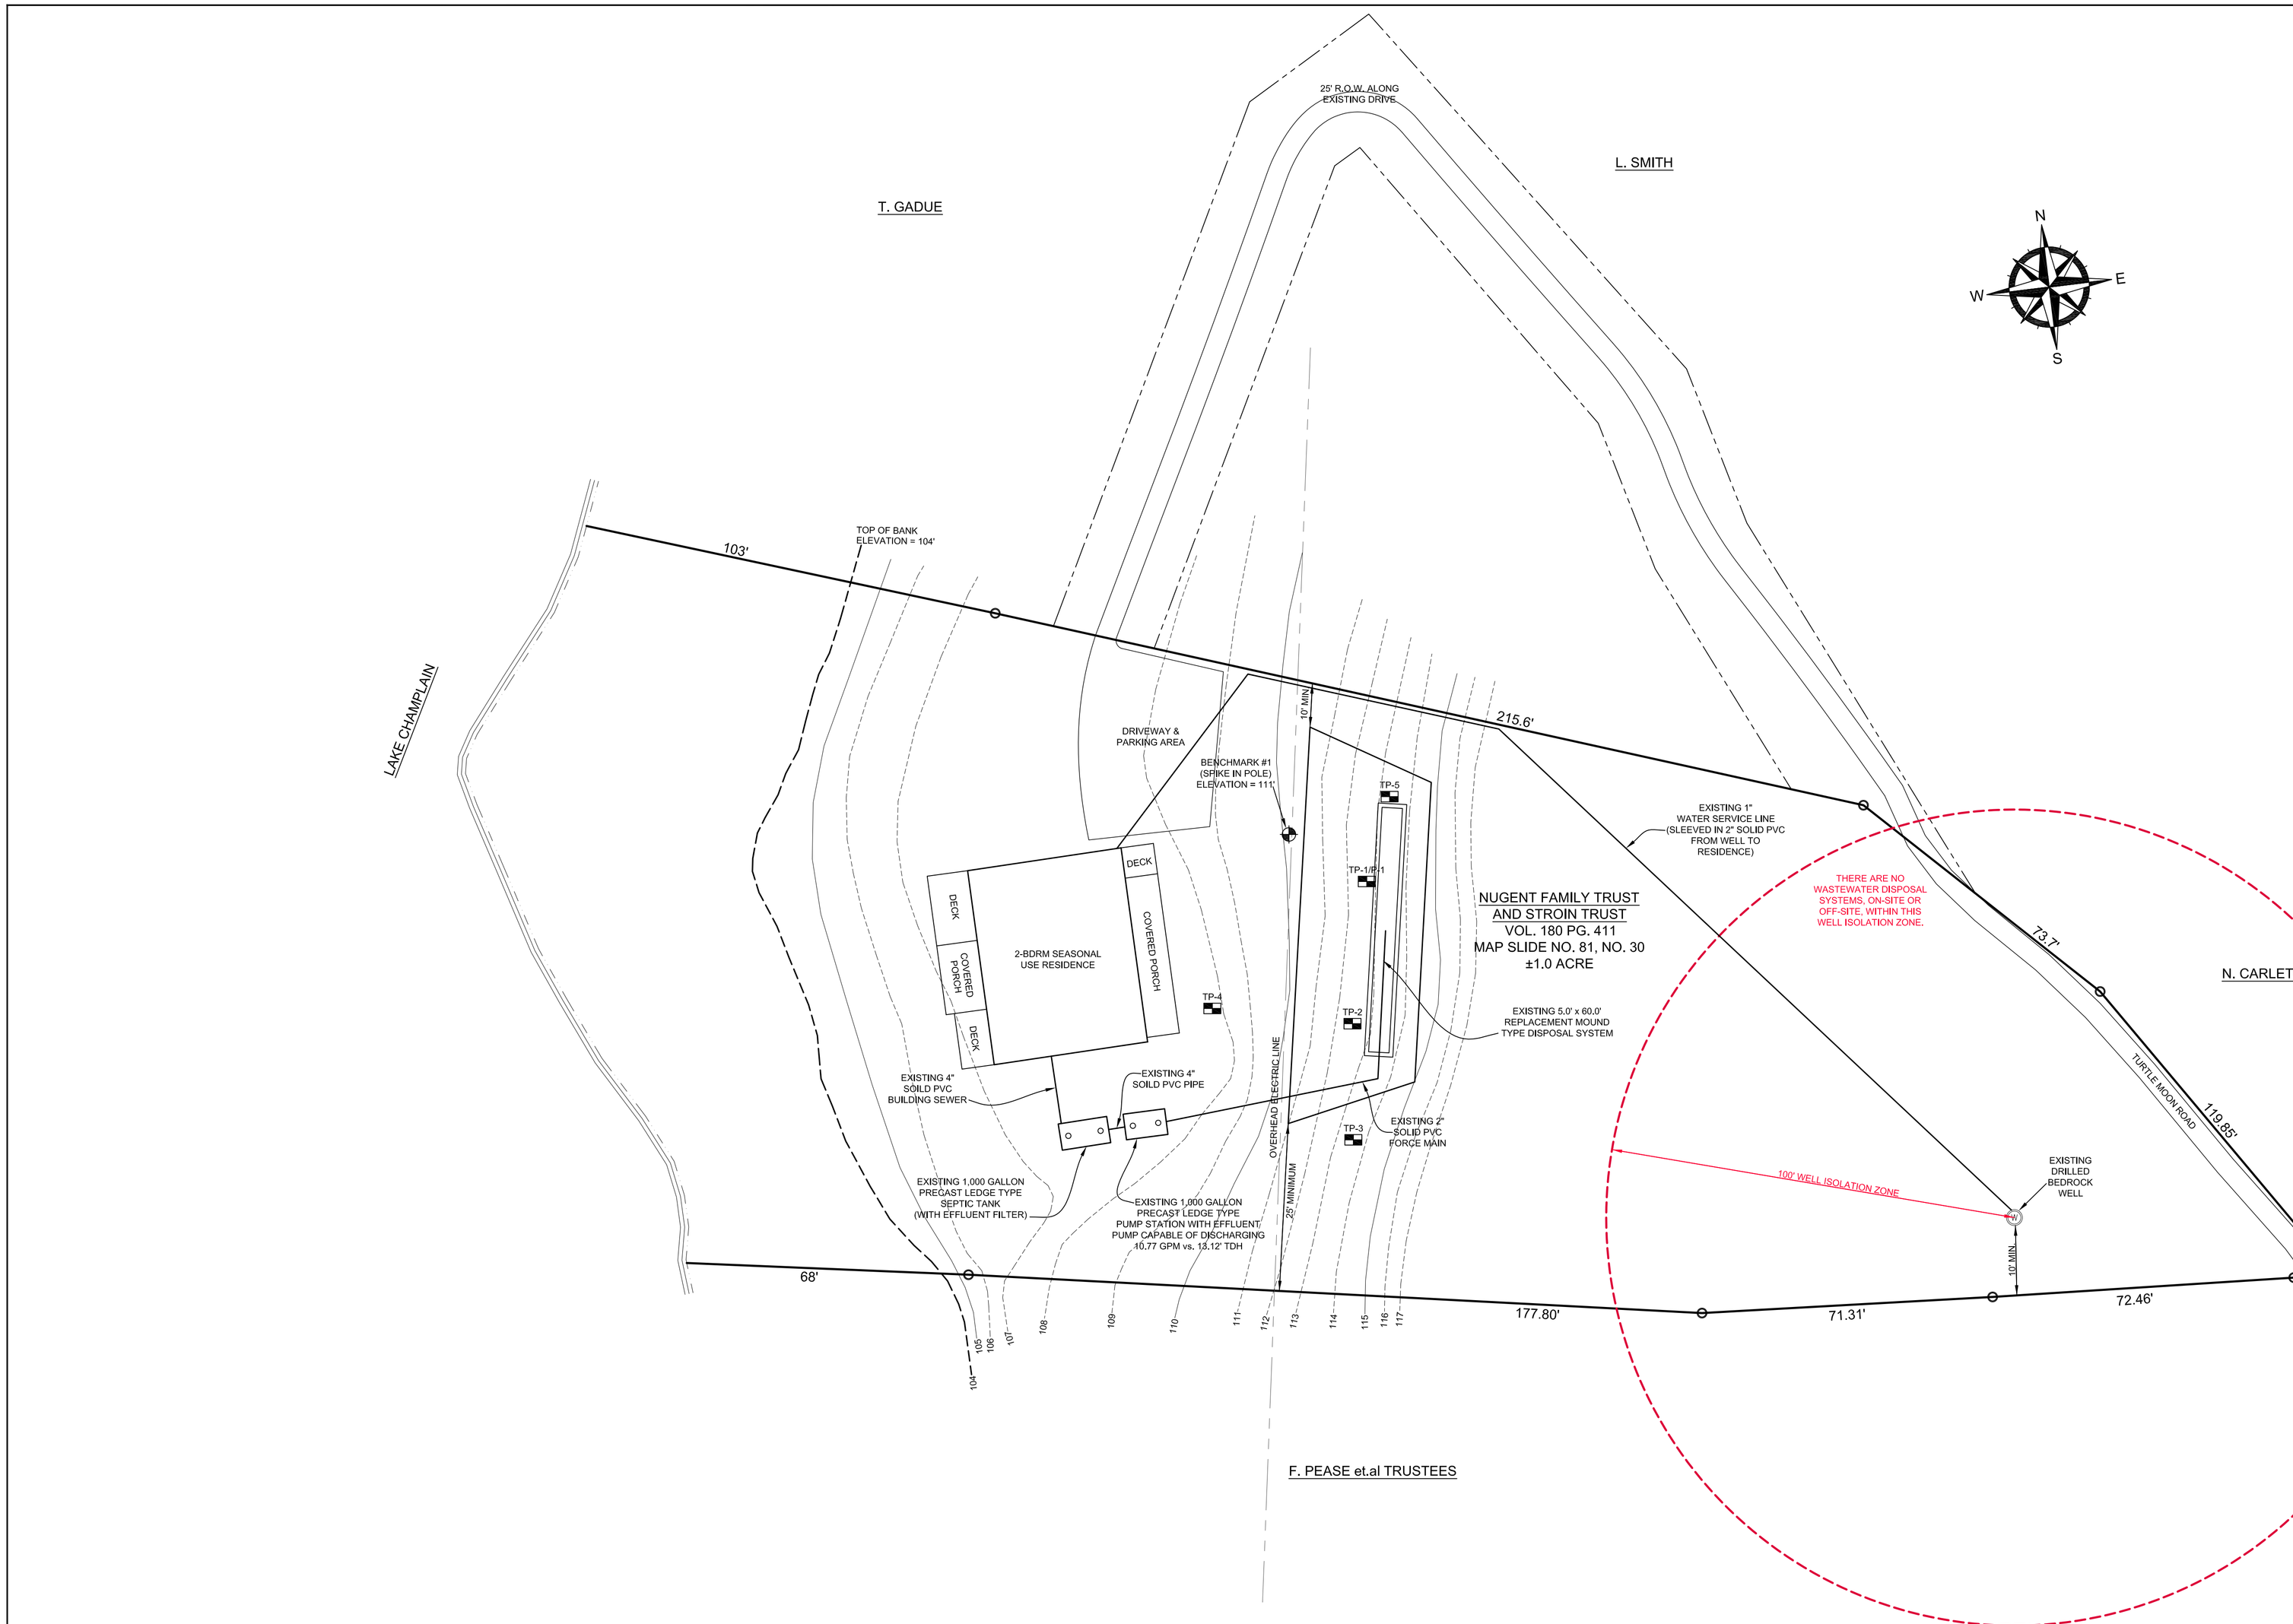

GENERAL LOCATION MAP

SCALE: 1"=2,000'±

LEGEND

- EXISTING GROUND CONTOUR
- EXISTING WATER SERVICE LINE
- EXISTING OVERHEAD ELECTRIC LINE
- EXISTING 25' R.O.W.
- EDGE OF ROAD
- EXISTING PROPERTY LINE
- EDGE OF LAKE CHAMPLAIN
- IRON PIPE FOUND
- TEMPORARY BENCHMARK
- TP-1/P-1 TEST PIT/PERCOLATION TEST
- WELL - DRILLED

GRAPHIC SCALE
(IN FEET)
20 0 10 20 40 80
(1"=20')

THE CONTRACTOR SHALL NOTIFY "DIGSAFE" AT 1-888-DIG-SAFE PRIOR TO ANY EXCAVATION.

No.	REVISION	DATE
1	Adjusted Septic Tank Placement	12-4-12
2	Adjusted Pump Station Placement	12-4-12
3	Adjusted Water Line Placement	12-4-12
4	Record Drawing with New Title	3-30-18
5	Added Rebuilt Residence and Removed Original	5-10-18
6	Added Driveway and Parking Area	5-10-18

"I hereby certify the installation and related information submitted is true and correct and that in the exercise of my reasonable professional judgement, the approved water and wastewater disposal systems have been installed in accordance with the design, all design conditions and the "as-built" drawing were inspected, were properly tested and successfully met those performance tests."

3-30-2018
Date

Stephen Revell, CPG
Licensed Class B Designer #178

AMERICAN INSTITUTE OF PROFESSIONAL GEOLOGISTS
CERTIFICATE NUMBER 6259
AIPG
STEPHEN REVELL
CERTIFIED PROFESSIONAL GEOLOGIST

LINCOLN APPLIED GEOLOGY, INC.
ENVIRONMENTAL CONSULTANTS
163 Revell Drive
(802) 453-4384
Web : www.lingvt.com
Lincoln, Vermont 05443
(802) 453-5399 (fax)
E-Mail: lingvt@lingvt.com

Nugent Family Trust & Stroin Trust
370 Turtle Moon Road
Charlotte, Vermont

RECORD DRAWING
showing Compliant Water & Wastewater Disposal Systems

LAG PROJECT # 10064
DATE: Nov. 19, 2010
SURVEYORS: W.A.R.
DRAWN BY: TAM
FIGURE: 1